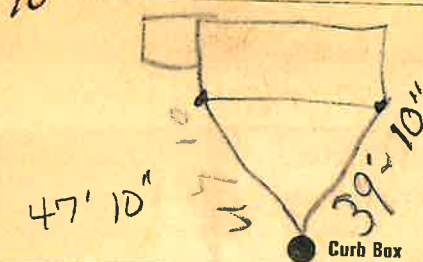


**Labor and Materials**

|              |                        |                     |          |
|--------------|------------------------|---------------------|----------|
| Copper       | Connection             | 3/4"                | \$ 2.70  |
| Lead         |                        |                     |          |
| Curb         | Cock Valve             | in.                 | \$ 2.39  |
|              | T.S. & V.              |                     |          |
| Service Box  | Short 3/4 x 1 1/2      |                     | \$ 1.45  |
| Old returned | Long 1 1/2 x 5/8       |                     |          |
|              | Duff. or Redway        |                     |          |
| 8 Ft.        | Copper                 | Pipe at             | \$ 2.16  |
|              | Cast Iron              |                     |          |
|              | Nipples                | in. at              | \$       |
|              | Bushings               | to in. at           | \$       |
|              | Red'g Inc'g            | Couplings to in. at | \$       |
|              | Union                  | in. at              | \$       |
|              | Meter                  | in. at              | \$       |
|              | Lbs. Br. Stone         | at                  | \$       |
|              | Lbs. Sand              | at                  | \$       |
|              | Bags Cement            | 'at                 | \$       |
|              | Paving Brick           | Mack Red Asphalt at | \$       |
|              | Lead Joints            | at                  | \$       |
|              | Leadite Joints         | at                  | \$       |
| 1            | Hrs. Foreman           | at                  | \$ .63   |
|              | Hrs. Common Labor      | at                  | \$       |
|              | Hrs. Common Labor      | at                  | \$       |
|              | Hrs. Mason             | at                  | \$       |
|              | Hrs. Mason's Helper    | at                  | \$       |
|              | Hrs. Compressor        | at                  | \$       |
|              | Compensation           | Los                 | \$ .02   |
|              | Trucking               |                     | \$ 1.-   |
|              | Builders' Use of Water | Patch               | \$ 5.-   |
| Total        |                        |                     | \$ 15.35 |

30-19 April 16 1930  
 Labor and Material Report  
 70 Sheridan St  
  
 6 Main Eley of Main at tap 5  
 Gate at TAX ID # 302.19-8-5 Gate at  
 Curb Box  
 New House  
 no measurements  
 8' to MAIN  
 3/4" copper