


St.  
Pl.  
Ave. No.

Name of Owner

71 SHERIDAN AVE

Labor and Mat'l. Report 19

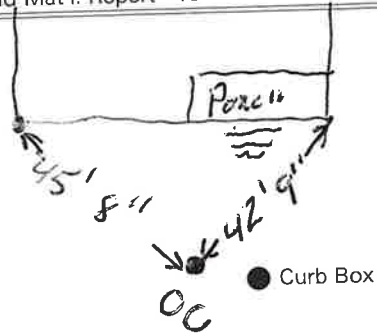

Main

Elev. of  
Main at tap

Gate at ●

● Gate at


TAX ID # 302.19.3-16

● Curb Box

Labor and Material Report

July 3 1924

Tap at P. # 71 Sheridan

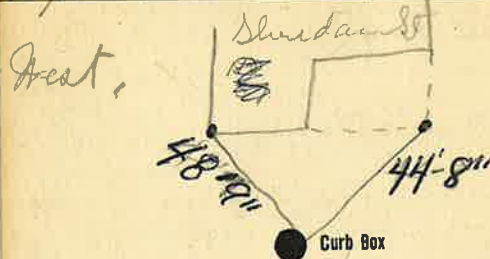

6" Main

Elev. of  
Main at tap

4 1/2

Gate at ●

● Gate at

● Curb Box

21' to MAIN  
3/4" GAT.

