


LABOR AND MATERIALS

1	Copper	} Connection $\frac{3}{4}$ "	\$
1	Lead		\$
1	Curb	} Cock Valve T.S. & V. $\frac{3}{4}$ in.	\$
1	Service box		} Short $3\frac{1}{2} \times 4\frac{1}{2}$ Long $4\frac{1}{2} \times 5\frac{1}{2}$ Buff or Rdway
22	Old returned		
22	Ft. $\frac{3}{4}$ in.	} Copper G.I. G.I.	} Pipe at \$
	Nipples		
	Bushings	to in. at \$	
	Red'g Inc'g	} Coupl'gs to in. at \$	
	Union		in. at \$
	Meter	in. at \$	
	Lead Joints	at \$	
	Compound Joints	at \$	
	Maintenance Foreman	\$	
	Hrs. Water Maint. Man-1	at \$	
	Hrs. Water Maint. Man-2	at \$	
	Hrs. Garage Foreman	at \$	
	Hrs. Labor	at \$	
	Hrs. Compressor	at \$	
	Compensation Ins. at \$	per C \$	
	Trucking	\$	
	Pay't Patch	\$	
	Tap by Giggard & Co.	\$	
	Mar. 24-59.	\$	
	O'head	\$	

St. Sheridan
Pl. 77
Ave. No. 77

Name of Owner Charles Mc Elmann

Labor and Mat'l. Report Mar. 24 1959

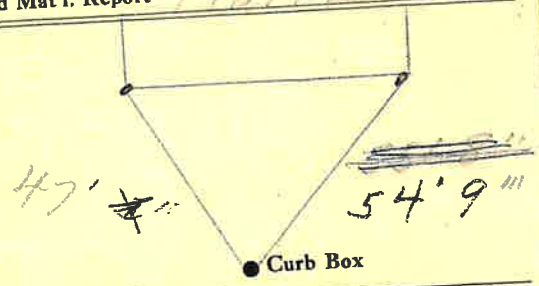

6" Main Elev. of Main at tap 5 1/2'

Gate at • Gate at •
TAX ID # 302.19-3-14

22' to MAIN • Curb Box
 $\frac{3}{4}$ " copper