

LABOR AND MATERIALS

1	Copper Lead	Connection	$\frac{3}{4}$	\$	1.23
1	Curb	Cock Valve T-S. & V.	$\frac{3}{4}$ in.	\$	1.68
1	Service Box Old returned	Short $3\frac{1}{2} \times 4\frac{1}{2}$ Long $4\frac{1}{2} \times 5\frac{1}{2}$ Buff. or Rdway		\$	1.54
24	Ft.	$\frac{3}{4}$ in.	Copper Galv Iron Cast Iron	Pipe at	17 \$ 4.08
	Nipples	in. at		\$	
	Bushings	to in. at		\$	
	Red'g Inc'g	Couplings to in. at		\$	
	Union	in. at		\$	
	Meter	in. at		\$	
	Lead Joints	at		\$	
	Leadite Joints	at		\$	
	Hrs. Foreman	at		\$	
3	Hrs. Chauffeur	at	62 1/2	\$	1.88
	Hrs. Tapper	at		\$	
5	Hrs. Labor	at	45	\$	2.25
	Hrs. Labor	at		\$	
	Hrs. Compressor	at		\$	
	Compensation Ins.			\$	.13
	Trucking			\$	1.-
	Builders Use of Water			\$	
	Tap by Penox			\$	
	Patch - 1/2 Sewer Dept			\$	2.50
				\$	
				\$	16.29

\$ 0 -- 1939

St.

Sheridan


Pl.

Ave. No. 91

Name of Owner

Bert Kaene

Labor and Mat'l. Report Aug 24 1939

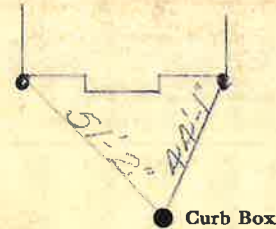

6 Main

Elev. of Main at tap 42

Gate at

Gate at

TAX ID# 302.19-3-8

Curb Box

24" to main  
3/4" copper

New House