



# LABOR AND MATERIALS

- 3/4 Copper } Connection \_\_\_\_\_ \$ \_\_\_\_\_
- Lead } \_\_\_\_\_ \$ \_\_\_\_\_
- Curb } Cock } \_\_\_\_\_ in. \_\_\_\_\_ \$ \_\_\_\_\_
- Valve } \_\_\_\_\_ \$ \_\_\_\_\_
- T.S. & V. } \_\_\_\_\_ \$ \_\_\_\_\_
- Service box { Short 3-1/2 x 4-1/2 } \_\_\_\_\_ \$ \_\_\_\_\_
- Old returned { Long 4-1/2 x 5-1/2 } \_\_\_\_\_ \$ \_\_\_\_\_
- 27 Ft. \_\_\_\_\_ in. { Copper } Pipe at \_\_\_\_\_ \$ \_\_\_\_\_
- G.I. } \_\_\_\_\_ \$ \_\_\_\_\_
- C.I. } \_\_\_\_\_ \$ \_\_\_\_\_
- Nipples \_\_\_\_\_ in. at \_\_\_\_\_ \$ \_\_\_\_\_
- Bushings \_\_\_\_\_ to \_\_\_\_\_ in. at \_\_\_\_\_ \$ \_\_\_\_\_
- Red'g \_\_\_\_\_
- Inc'g \_\_\_\_\_
- Union \_\_\_\_\_ in. at \_\_\_\_\_ \$ \_\_\_\_\_
- Meter \_\_\_\_\_ in. at \_\_\_\_\_ \$ \_\_\_\_\_
- \_\_\_\_\_ \$ \_\_\_\_\_
- Compound Joints at \_\_\_\_\_ \$ \_\_\_\_\_
- Maintenance Foreman \_\_\_\_\_ \$ \_\_\_\_\_
- Hrs. Water Maint. Man - 1 at \_\_\_\_\_ \$ \_\_\_\_\_
- Hrs. Water Maint. Man - 2 at \_\_\_\_\_ \$ \_\_\_\_\_
- Hrs. Garage Foreman \_\_\_\_\_ at \_\_\_\_\_ \$ \_\_\_\_\_
- Hrs. Labor \_\_\_\_\_ at \_\_\_\_\_ \$ \_\_\_\_\_
- Hrs. Compressor at \_\_\_\_\_ \$ \_\_\_\_\_
- \_\_\_\_\_ \$ \_\_\_\_\_
- Trucking \_\_\_\_\_ \$ \_\_\_\_\_
- Pav't Patch \_\_\_\_\_ \$ \_\_\_\_\_
- \_\_\_\_\_ \$ \_\_\_\_\_
- \_\_\_\_\_ \$ \_\_\_\_\_
St. Sheridan  
 Pl. Ave. No. 10

Name of Owner \_\_\_\_\_  
 TAX ID # 302.19-11-7.2

Labor and Mat'l. Report 19

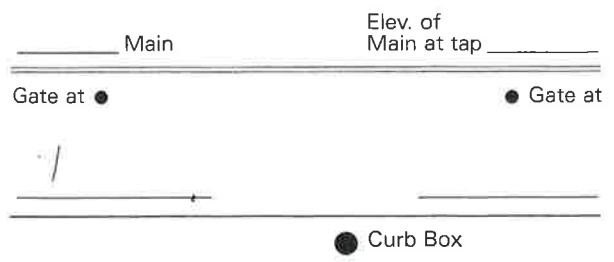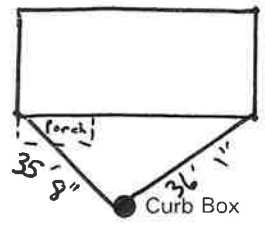

*sewer 20' OF SDR 35*