

## LABOR AND MATERIALS

1	Copper Lead	{ Connection	3/4		\$ 2.29
1	Curb	{ Cock Valve T.S. & V. }	3/4 in.		\$ 2.70
1	Service box Old returned	{ Short 3 1/2 x 4 1/2 Long 4 1/2 x 5 1/2 Buff or Rdway }			\$ 4.25
10	Ft. 3/4 in.	{ Copper G.I. G.I. }	Pipe at	35	\$ 3.50
	Nipples	in. at			\$
	Bushings	to in. at			\$
	Red'g Inc'g	{ Coupl'gs	to in. at		\$
	Union	in. at			\$
	Meter	in. at			\$
	Lead Joints	at			\$
	Compound Joints	at			\$
	Hrs. Water Maint. Man-1	at			\$
4	Hrs. Water Maint. Man-2	at	1.02		\$ 4.08
16	Hrs. Labor	at	91		\$ 14.56
	Hrs. Labor	at			\$
2	Hrs. Compressor	at	1.20		\$ 2.40
	Compensation Ins. at \$2.226 per C.				\$ 4.1
	Trucking				\$ 1.00
	Pav't Patch				\$ 5.40
	Tap by Moquin				\$
	O'head				\$
					\$ 40.59

1970/50

St.  
PT  
Ave. No. 92


Sheridan

---

Name of Owner

Jammons.

Labor and Mat'l. Report Sept 18 19 50

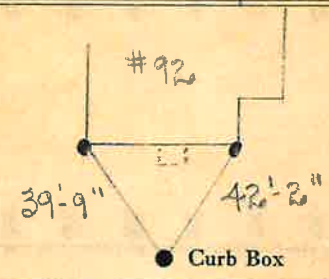

6" Main Elev. of  
Main at tap 5'

---

Gate at ● ● Gate at

TAX ID# 302.19-7-4

● Curb Box

10' to MAIN  
3/4" copper