

LABOR AND MATERIALS


1	Copper Lead	Connection	3/4"	\$
1	Curb	Cock Valve T.S. & V.	3/4" in.	\$
1	Service box	Short 3 1/2 x 4 1/2		
	Old returned	Long 4 1/2 x 5 1/2		
		Buff or Rdway		\$
10	3/4 in. Ft.	Copper G.I. C.I.	Pipe at	\$
	Nipples	in. at		\$
	Bushings	to in. at		\$
	Red'g Inc'g	Coupl'gs to in. at		\$
	Union	in. at		\$
	Meter	in. at		\$
	Lead Joints	at		\$
	Compound Joints	at		\$
	Maintenance Foreman			\$
	Hrs. Water Maint. Man-1	at		\$
	Hrs. Water Maint. Man-2	at		\$
	Hrs. Garage Foreman	at		\$
	Hrs. Labor	at		\$
	Hrs. Compressor	at		\$
	Compensation Ins. at \$	per C.		\$
	Trucking			\$
	Pay't Patch			\$
	Tap by Gifford & Co			\$
				\$
	O'head			\$

Tap by Gifford & Co
1-8-57

Sheridan St. Ave. No. 94

Name of Owner
Sovetts

Labor and Mat'l. Report Jan 8 1957

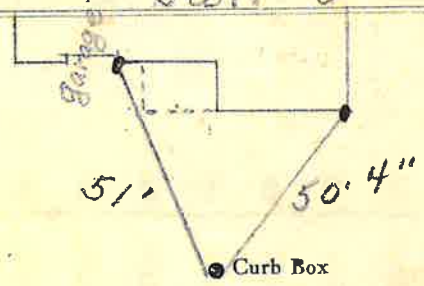

6" Main Elev. of Main at tap 5'

Gate at • Gate at •

TAX ID # 302.19-7-5

• Curb Box

10' to main
3/4" copper