


LABOR AND MATERIALS

1	Copper Lead	Connection	3/4"	\$	2.71
1	Curb	Cock Valve T.S. & V.	3/4 in.	\$	3.83
1	Service box	Short 3 1/2 x 4 1/2		\$	4.69
	Old returned	Long 4 1/2 x 5 1/2		\$	
		Buff or Rdway		\$	
12	Ft. 3/4 in.	Copper Pipe at	45	\$	5.40
		G.I.		\$	
		C.I.		\$	
	Nipples	in. at		\$	
	Bushings	to in. at		\$	
	Red'g			\$	
	Inc'g	Coupl'gs to in. at		\$	
	Union	in. at		\$	
	Meter	in. at		\$	
	Lead Joints at			\$	
	Compound Joints at			\$	
	Maintenance Foreman			\$	1.400
	Hrs. Water Maint. Man-1 at			\$	
4	Hrs. Water Maint. Man-2 at	1.24		\$	4.96
	Hrs. Garage Foreman at			\$	
8	Hrs. Labor at			\$	9.04
				\$	1.50
1	Hrs. Compressor at			\$.60
	Compensation Ins. at \$	4.29 per C		\$	1.58
	Trucking			\$	7.20
	Pav't Patch			\$	
	Tap by Gifford			\$	
		5-31-55		\$	
	O'head			\$	
				\$	41.93

Sheridan St. Pl. Ave. No. 98

Name of Owner Keene

Labor and Mat'l. Report May 31 1955

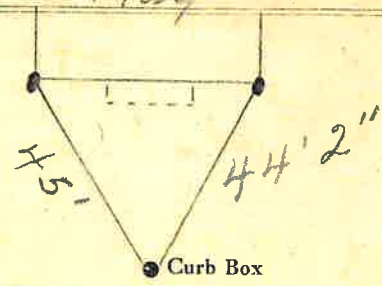

6 Main Elev. of Main at tap 5'

Gate at • Gate at

TAX ID# 302.19-7-7

• Curb Box

12' to main
3/4" Copper