

LABOR AND MATERIALS


1	Copper Lead	Connection	\$
1	Curb	Cook Valve T. S. & V. } in.	\$
	Service box	Short 3 1/2 x 4 1/2 Long 4 1/2 x 5 1/2 Buff or Rdway	\$
	Old returned		
10	Ft. 3/4 in.	Copper } Pipe at	\$
		G. I. }	
		C. I. }	
	Nipples	in. at	\$
	Bushings	to in. at	\$
	Red'g } Inc'g }	Coupl'gs to in. at	\$
	Union	in. at	\$
	Meter	in. at	\$
	Lead Joints	at	\$
	Compound Joints	at	\$
	Maintenance Foreman		\$
	Hrs. Water Maint. Man-1	at	\$
	Hrs. Water Maint. Man-2	at	\$
	Hrs. Garage Foreman	at	\$
	Hrs. Labor	at	\$
	Hrs. Compressor	at	\$
	Compensation Ins.	at \$ per C	\$
	Trucking		\$
	Pav't Patch		\$
			\$
			\$
			\$
	O'head		\$
			\$

SHERDIAN St. Pl. Ave. No. 11

Name of Owner

TAX ID # 302.15-13-15

Labor and Mat'l. Report 19 78

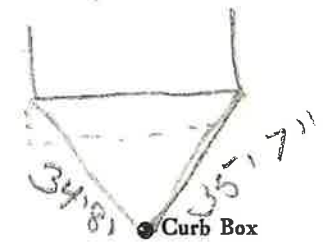

6 Main Elev. of Main at tap 5

Gate at • Gate at •

10' to MAIN • Curb Box