


LABOR AND MATERIALS

3/4 Copper } Connection _____ \$ _____
Lead }
 _____ Curb } Cock _____ in. _____ \$ _____
 _____ } Valve _____
 _____ } T.S. & V. }
 _____ Service box { Short 3-1/2 x 4-1/2 } _____ \$ _____
 _____ Old returned { Long 4-1/2 x 5-1/2 } _____ \$ _____
27 Ft. _____ in. { Copper } Pipe at _____ \$ _____
 _____ } G.I. }
 _____ } C.I. }
 _____ Nipples _____ in. at _____ \$ _____
 _____ Bushings _____ to _____ in. at _____ \$ _____
 _____ Red'g _____
 _____ Inc'g _____
 _____ Union _____ in. at _____ \$ _____
 _____ Meter _____ in. at _____ \$ _____
 _____ \$ _____
 _____ Compound Joints at _____ \$ _____
 _____ Maintenance Foreman _____ \$ _____
 _____ Hrs. Water Maint. Man - 1 at _____ \$ _____
 _____ Hrs. Water Maint. Man - 2 at _____ \$ _____
 _____ Hrs. Garage Foreman _____ at _____ \$ _____
 _____ Hrs. Labor _____ at _____ \$ _____
 _____ Hrs. Compressor at _____ \$ _____
 _____ \$ _____
 _____ Trucking _____ \$ _____
 _____ Pav't Patch _____ \$ _____
 _____ \$ _____
 _____ \$ _____
Sheridan St. Ave. No. 12

Name of Owner
TAY ID # 302.19-11-7.1

Labor and Mat'l. Report 19

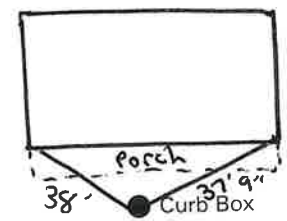

_____ Main Elev. of Main at tap _____
 Gate at ● Gate at ●

 ● Curb Box

sum 20' OF SDR 35