


Labor and Material Report Oct 27 1936

13 Sheridan St 3/4 Tap
Hn Vis.

East

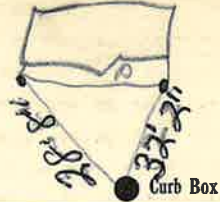

2\" gal Main

Elev of Main at tap 5

Gate at ●

● Gate at

● Curb Box

9' to main
3/4\" copper


Att.

St. _____
Pl. _____
Ave. No. _____

Name of Owner

13 Sheridan

Labor and Mat'l. Report 19 _____

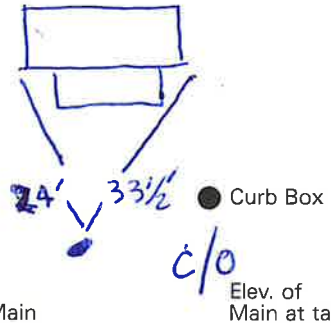

_____ Main

Elev. of Main at tap _____

Gate at ●

● Gate at

TAX ID# 302.15-13-14

● Curb Box

