


LABOR AND MATERIALS

3/4	Copper	Connection	_____	\$	_____
	Lead	Cock	_____	\$	_____
	Curb	Valve	_____ in.	\$	_____
		T.S. & V.	_____	\$	_____
	Service box	Short 3-1/2 x 4-1/2	_____	\$	_____
	Old returned	Long 4-1/2 x 5-1/2	_____	\$	_____
27	Ft.	Copper	_____ in.	\$	_____
		G.I.	_____	\$	_____
		C.I.	_____	\$	_____
	Nipples	_____ in.	at _____	\$	_____
	Bushings	_____ to _____ in.	at _____	\$	_____
	Red'g	_____		\$	_____
	Inc'g	_____		\$	_____
	Union	_____ in.	at _____	\$	_____
	Meter	_____ in.	at _____	\$	_____
	_____			\$	_____
	Compound Joints	at _____		\$	_____
	Maintenance Foreman	_____		\$	_____
	Hrs. Water Maint. Man - 1	at _____		\$	_____
	Hrs. Water Maint. Man - 2	at _____		\$	_____
	Hrs. Garage Foreman	_____ at _____		\$	_____
	Hrs. Labor	_____ at _____		\$	_____
	Hrs. Compressor	at _____		\$	_____
	_____			\$	_____
	Trucking	_____		\$	_____
	Pav't Patch	_____		\$	_____
	_____			\$	_____
	_____			\$	_____
Sheridan St. Ave No. 14
 Name of Owner
 TAX ID # 302.19.11.8
 Labor and Mat'l. Report 19 2005

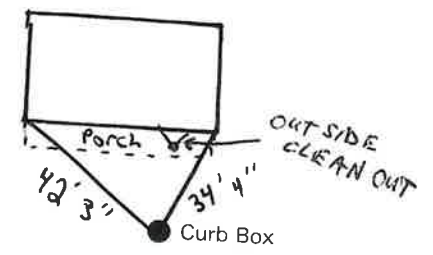

_____ Main Elev. of Main at tap _____
 Gate at ● Gate at ●

 ● Curb Box

Some 20' OF SDR35