

Labor and Materials


1	Copper } Connection.....	\$ 3.20
1	Lead } Cock }	
	} Valve }	\$ 1.00
	} T. S. & V. }	
1	Service Box } Short 3 1/2 x 4 1/2 }	\$ 1.20
	Old returned } Long 4 1/2 x 5 1/2 }	
	} Buff. or Rdway }	
1 1/2	Ft. 3/4 in. } Copper } Pipe at.....	\$ 2.80
	} Galv. Iron }	
	} Cast Iron }	
	Nipples..... in. at.....	\$
	Bushings..... to..... in. at.....	\$
	Red'g } Couplings..... to..... in. at.....	\$
	Inc'g }	
	Union..... in. at.....	\$
	Meter..... in. at.....	\$
	Lbs Br. Stone at.....	\$
	Lbs. Sand at.....	\$
	Bags Cement at.....	\$
	Paving Brick } Mack } at.....	\$
	} Red }	
	} Asphalt }	
	Lead Joints at.....	\$
	Leadite Joints at.....	\$
2	Hrs. Foreman at.....	\$ 1.25
3	Hrs. Common Labor at.....	\$ 1.50
8	Hrs. Common Labor at.....	\$ 3.25
	Hrs. Mason at.....	\$
	Hrs. Mason's Helper at.....	\$
	Hrs. Compressor at.....	\$
	Compensation Ins.....	\$ 1.17
	Trucking.....	\$ 1.00
	Builders' Use of Water.....	\$
	Total \$ 15.53	

26-141

Labor and Material Report

Sept 17 19 26

138 Sherman Ave

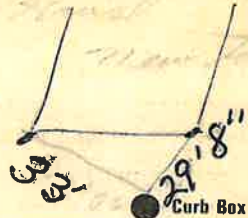

Main

Elev. of Main at tap

Gate at ●

● Gate at

TAX ID # 309.7-4-5

● Curb Box

13' to main ?

3/4" copper