

Labor and Material Report

4-21-1931

143 Sherman Ave

No Measurement

● Curb Box

6 Main

Elev of Main at tap

Gate at ●

● Gate at

● Curb Box

This Tap
In Intersection
of Clayton +
Sherman Ave.

~~St.~~

~~Pl.~~

Sherman


Ave. No. 143

Name of Owner

TAX ID # 302.19.13-23

Labor and Mat'l. Report

Nov. 25 1952

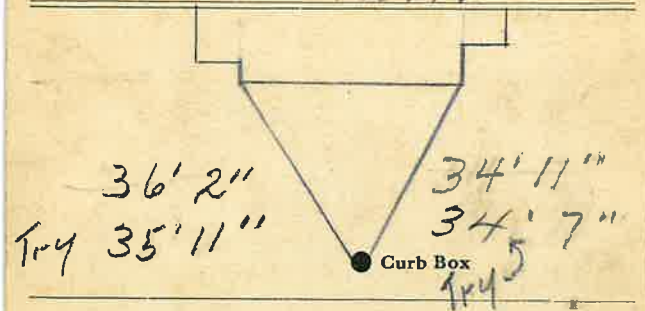

Main

Elev. of Main at tap

Gate at ●

● Gate at

25' to MAIN

3/4" COPPER

● Curb Box

This tap made
to take place of one
in intersection of
Sherman & Clayton
Avenues

LSM-5C 5 15-48

Labor and Materials

1	Copper	Connection	\$ 2.60
1	Curb	Cock Valve T. S. & V. in.	\$ 2.27
1	Service Box	Short 3 1/2 X 4 1/2	} Buff or Rdway	\$ 1.35
	Old returned	Long 4 1/2 X 5 1/2		
24	Ft.	Copper Galv. Iron Cast Iron	Pipe at	\$ 4.32
	Nipples in. at	\$
	Bushings to in. at	\$
	Red'g Inc'g	Couplings to in. at
	Union in. at	\$
	Meter in. at	\$
	Lbs. Br. Stone	at	\$
	Lbs. Sand	at	\$
	Bags Cement	at	\$
	Paving Brick	Mack Red Asphalt	at	\$
	Lead Joints	at	\$
	Leadite Joints	at	\$
3/4	Hrs. Foreman	at	\$ 4.7
2	Hrs. Common Labor	Tapper	at	\$ 1.00
1.6	Hrs. Common Labor	at	\$ 7.20
	Hrs. Mason	at	\$
	Hrs. Mason's Helper	at	\$
	Hrs. Compressor	at	\$
	Compensation Ins	\$.26
	Trucking	\$ 1.00
	Builders' Use of Water	\$

Total \$ 20.50

LABOR AND MATERIALS

1	Copper	Connection	\$
1	Lead	\$
1	Curb	Cock Valve T. S. & V. in.	\$
1	Service box	Short 3 1/2 X 4 1/2	} Buff or Rdway	\$
	Old returned	Long 4 1/2 X 5 1/2		
25	Ft.	Copper G. I. C. I.	Pipe at	\$
	Nipples in. at	\$
	Bushings to in. at	\$
	Red'g Inc'g	Couplings to in. at
	Union in. at	\$
	Meter in. at	\$
	Lead Joints	at	\$
	Compound Joints	at	\$
	Hrs. Water Maint. Man-1	at	\$
	Hrs. Water Maint. Man-2	at	\$
	Hrs. Labor at	\$
	Hrs. Labor at	\$
	Hrs. Compressor	at	\$
	Compensation Ins.	at \$ per C.	\$
	Trucking	\$
	Pay't Patch	\$
	Tap by	9188015d	\$
		11-25-52	\$
	O'head	\$