

Labor and Material Report

4-21-1931

145 Sherman Ave

● Curb Box

6" Main

Elev of Main at tap 5'

Gate at ●

● Gate at


● Curb Box

27-143

Labor and Material Report

Dec 19 1927

Top at 145 Sherman Ave

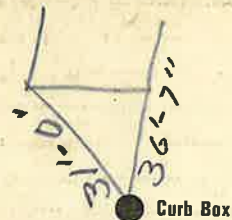

● Curb Box

6" Main

Elev. of Main at tap 5'

Gate at ●

TAX ID # 302.19-13-21

● Gate at

● Curb Box

New House
25' to main
3/4" copper

Labor and Materials

1	Copper } Connection		\$ 2.60
	Lead		
1	Curb } Cock Valve } in.		\$ 2.27
1	Service Box } Short 3/4 x 1/2 } Old returned } Long 1/2 x 3/4 } } Built on Rdway }		\$ 1.38
24	Ft. in. } Copper } } Galv. Iron } } Cast Iron }	Pipe at	\$ 4.32
	Nipples	in. at	\$
	Bushings	to in. at	\$
	Red'g } Inc'g } Couplings	to in. at	\$
	Union	in. at	\$
	Meter	in. at	\$
	Lbs. Br. Stone	at	\$
	Lbs. Sand	at	\$
	Bags Cement	at	\$
	Paving Brick } Mack } } Red } } Asphalt }	at	\$
	Lead Joints	at	\$
	Leadite Joints	at	\$
3/4	Hrs. Foreman	at	\$ 4.7
7	Hrs. Common Labor	at Tapper	\$ 1. -
16	Hrs. Common Labor	at	\$ 7.20
	Hrs. Mason	at	\$
	Hrs. Mason's Helper	at	\$
	Hrs. Compressor	at	\$
	Compensation Ins.		\$.26
	Trucking		\$ 1. -
	Builders' Use of Water	no pot 6	\$ -
Total \$			20.50

Labor and Materials

1	Copper } Connection		\$
	Lead		
1	Curb } Cock Valve } } T-S & V }	in.	\$
	Service Box } Short 3/4 x 1/2 } Old returned } Long 1/2 x 3/4 } } Built on Rdway }		\$
25	Ft. in. } Copper } } Galv. Iron } } Cast Iron }	Pipe at	\$
	Nipples	in. at	\$
	Bushings	to in. at	\$
	Red'g } Inc'g } Couplings	to in. at	\$
	Union	in. at	\$
	Meter	in. at	\$
	Lbs. Br. Stone	at	\$
	Lbs. Sand	at	\$
	Bags Cement	at	\$
	Paving Brick } Mack } } Red } } Asphalt }	at	\$
	Lead Joints	at	\$
	Leadite Joints	at	\$
	Hrs. Foreman	at	\$
	Hrs. Common Labor	at	\$
	Hrs. Common Labor	at	\$
	Hrs. Mason	at	\$
	Hrs. Mason's Helper	at	\$
	Hrs. Compressor	at	\$
	Compensation Ins.		\$
	Trucking		\$
	Builders' Use of Water		\$
Total \$			