


Labor and Materials

1	Copper	Connection	1"	\$	7.40
	Lead				
1	Curb	Cock Valve	1" in	\$	9.47
		T. S. & V.			
1	Service Box	Short	3 1/2 x 4 1/2	\$	1.75
	Old returned	Long	4 1/2 x 5 1/2		
		Buff. or Rdway			
19	Ft.	3/4" in.	Copper Galv Iron Cast Iron	Pipe at	15 \$ 2.75
	Nipples	in. at		\$	
	Bushings	to in. at		\$	
	Red'g Inc'g	Conplings to in. at		\$	
	Union	in. at		\$	
	Meter	in. at		\$	
	Lead Joints	at		\$	
	Leadite Joints	at		\$	
	Hrs. Foreman	at		\$	
1	Hrs. Chauffeur	at		\$	5.00
6	Hrs. Tapper	at		\$	3.00
	Hrs. Labor	at		\$	
12	Hrs. Labor	at		\$	3.40
2	Hrs. Compressor	at		\$	1.75
	Compensation Ins.			\$	1.00
	Trucking			\$	1.00
	Builders Use of Water	Patch		\$	9.00
		Tony Kossell		\$	
				\$	
				\$	
St. Sherman
Pl. Ave. No. 25

Name of Owner
Alfred S. Clark

Labor and Mat'l. Report May 24 1938

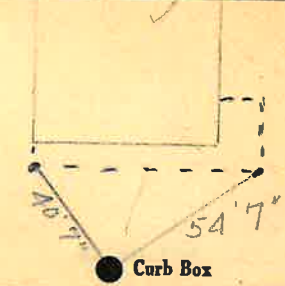

6 Main Elev. of Main at tap 5

Gate at TAX ID # 302.20-14-23 Gate at

19' to main
3/4" Copper