


LABOR AND MATERIALS

1	Copper	Connection	3/4"	\$
1	Curb	Cock Valve	3/4" (MARK II)	\$
1	Service box	Short 3 1/2 x 4 1/2	} 4'-5"	\$
	Old returned	Long 4 1/2 x 5 1/2		
		Buff or Rdway		
24	Ft. 3/4 in.	Copper	Pipe at	\$
	Nipples	in. at		\$
	Bushings	to in. at		\$
	Red'g Inc'g	Coupl'gs to in. at		\$
	Union	in. at		\$
	Meter	in. at		\$
	Lead Joints	at		\$
	Compound Joints	at		\$
	Maintenance Foreman			\$
	Hrs. Water Maint. Man-1	at		\$
	Hrs. Water Maint. Man-2	at		\$
	Hrs. Garage Foreman	at		\$
	Hrs. Labor	at		\$
	Hrs. Compressor	at		\$
	Compensation Ins. at \$	per C		\$
	Trucking			\$
	Pav't Patch			\$
	TAP MADE BY GIFFORD & Co.			\$
	O'head	Dec-4-1972		\$

SHERMAN Ave. No. 31

Name of Owner
DR. RICHARD D. GARRETTE

Labor and Mat'l. Report Dec 4 1972

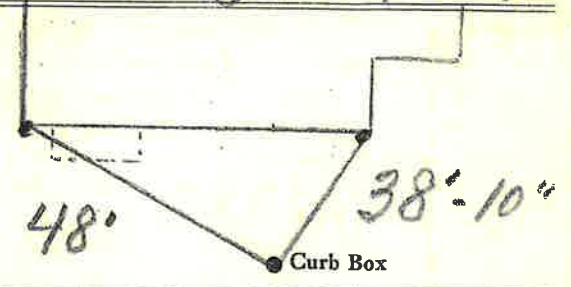

6" Main Elev. of Main at tap 5'

Gate at • Gate at •

TAX ID # 302.20-14-21

• Curb Box
24' to main
3/4" copper