


### Labor and Materials

Lead Connection <sup>1/2</sup>	\$
Curb Cock	\$
Service Box (Short 3 1/2 x 4 1/2)	\$
Old returned (Long 4 1/2 x 5 1/2)	\$
Buffala	
Ft. <sup>3/4</sup> in. Pipe at	\$
COPPER (1992)	\$
Nipples in. at	\$
Bushings to in. at	\$
Red'g Coup to in. at	\$
Inc'g Coup to in. at	\$
Union in. at	\$
Meter in. at	\$
Cu. Yds. Br. Stone at	\$
Cu. Yds. Sand at	\$
Bags Cement at	\$
Paving Brick { Mack Red Asphalt } at	\$
<sup>2</sup> Hrs. Foreman at	\$
<sup>6</sup> Hrs. Common Labor at	\$
Hrs. Mason at	\$
Hrs. at	\$
Hrs. at	\$
<sup>no</sup> Builders' Use of Water	\$
Track	\$
at	\$
at	\$
at	\$
Total	\$ 8.81

Labor and Material Report

Aug 9 19

32

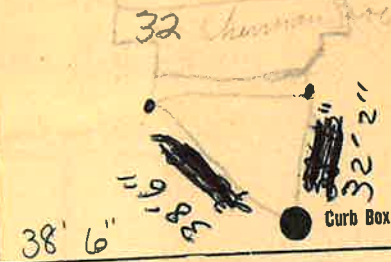

6" Main

Elev. of Main at tap

4'

Gate at

TAX ID # 302.20-20-8

Gate at

Curb Box

RENEWAL TAP 1992  
9' to main  
3/4" copper