


Labor and Material Report

June 3

19 25

35 Sherman Ave

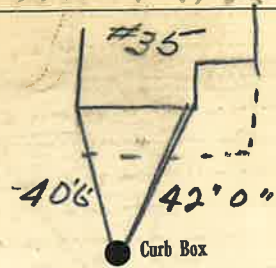

Main

Elev. of Main at tap

Gate at ●

● Gate at

● Curb Box

Measurement to
36 Sherman Ave


W.B.

Tap made 10-14-1908

Labor and Material Report

July 13 19 36

35 Sherman Ave

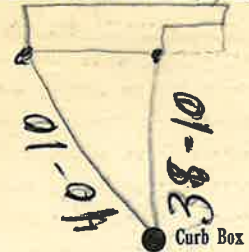

6 Main

Elev. of Main at tap

4 1/2

Gate at ●

● Gate at

TAX ID # 302.20.14.20

● Curb Box

Old sheet off at
main

22' to the main
3/4" copper *W.B.*

Labor and Materials

| | |
|---|------------------|
| Copper } Connection..... | \$..... |
| Lead } | \$..... |
| Curb { Cock Valve T.S.&V. } | in \$..... |
| Service Box { Short 3 1/2 x 4 1/2 } | \$..... |
| Old returned { Long 4 1/2 x 5 1/2 } | \$..... |
| { Buff. or Rdway } | \$..... |
| Ft..... in. { Copper Galv. Iron } Pipe at | \$..... |
| { Cast Iron } | \$..... |
| Nipples in. at | \$..... |
| Bushings to in. at..... | \$..... |
| Red'g } Couplings..... to..... in.at..... | \$..... |
| Inc'g } | \$..... |
| Union..... in. at | \$..... |
| Meter..... in. at | \$..... |
| Lbs. Br. Stone at | \$..... |
| Lbs. Sand at | \$..... |
| Bags Cement at | \$..... |
| Paving Brick { Mack Red Asphalt } at | \$..... |
| Lead Joints at | \$..... |
| Leadite Joints at | \$..... |
| Hrs. Foreman at | \$..... |
| Hrs. Common Labor at | \$..... |
| Hrs. Common Labor at | \$..... |
| Hrs. Mason at | \$..... |
| Hrs. Masons Helper at | \$..... |
| Hrs. Compressor at | \$..... |
| Compensation Ins | \$..... |
| Trucking | \$..... |
| Builders Use of Water | \$..... |
| Total \$..... | |

Labor and Materials

| | |
|--|------------------|
| Copper } Connection..... | \$..... |
| Lead } | \$..... |
| Curb { Cock Valve T.S.&V. } | in \$..... |
| Service Box { Short 3 1/2 x 4 1/2 } | \$..... |
| Old returned { Long 4 1/2 x 5 1/2 } | \$..... |
| { Buff. or Rdway } | \$..... |
| 32 Ft..... in. { Copper Galv. Iron } Pipe at 15..... | \$ 3.30 |
| { Cast Iron } | \$..... |
| Nipples in. at | \$..... |
| Bushings to in. at..... | \$..... |
| Red'g } Couplings..... to..... in.at..... | \$..... |
| Inc'g } | \$..... |
| Union..... in. at | \$..... |
| Meter..... in. at | \$..... |
| Lbs. Br. Stone at | \$..... |
| Lbs. Sand at | \$..... |
| Bags Cement at | \$..... |
| Paving Brick { Mack Red Asphalt } at | \$..... |
| Lead Joints at | \$..... |
| Leadite Joints at | \$..... |
| Hrs. Foreman at | \$..... |
| Hrs. Common Labor at | \$..... |
| Hrs. Common Labor at | \$..... |
| Hrs. Mason at | \$..... |
| Hrs. Masons Helper at | \$..... |
| Hrs. Compressor at | \$..... |
| Compensation Ins | \$..... |
| Trucking | \$..... |
| Builders Use of Water Patch..... | \$ 9- |
| Total \$..... | |