


36

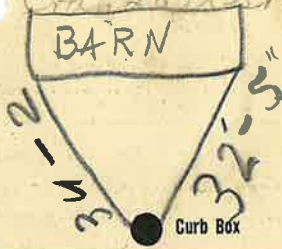

34' 2"

Curb Box

This is the GARAGE in the REAR

10" Main

Elev. of Main at tap

4 1/2'

Gate at ●

● Gate at

● Curb Box

8' to main
1" GAL

36 Lot at 36 Sherman Ave



TRY 33' 8"

TRY 23' 7"

Curb Box

10" Main

Elev. of Main at tap

4 1/2'

Gate at ●

● Gate at

TAX ID # 302.20-20.9

● Curb Box

7' to main
1" GAL.

