

Labor and Material Report

Aug.



6" Main Elev. of Main at tap 4 1/2

Gate at ● ● Gate at

● Curb Box


37-39 SHERMAN
KA
6-6-2001

SHERMAN

St. Ave. No. 37-39

Name of Owner
PHILIP J. FRAGASSI

Labor and Mat'l. Report ~~KA~~ # 6-7-2001

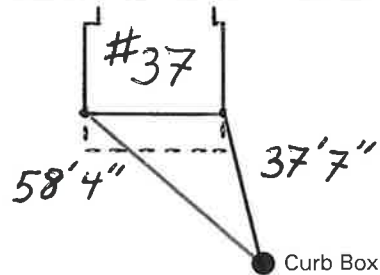

6" Main Elev. of Main at tap 4 FT

Gate at ● ● Gate at

24' to main
1" GAL.

● Curb Box

MEASUREMENTS TO PORCH
CORNERS @ 37 SHERMAN

LEFT RIGHT
53' 6" 31' 0"

#37
TAX ID# 302.20-14-19

Labor and Materials

1 Lead Connection ^{3/4"} at \$
 1 Curb Cock at \$
 1 Service Box (Short 3 1/2 x 4)
 Old returned (Long 4 1/2 x 5 1/2) at \$
 Buffalo
 24 Ft. 1 in. G. I. Pipe at \$
 Nipples in. at \$
 Bushings 1" to 1 1/2" in. at \$
 Red'g Coup to in. at \$
 Inc'g Coup to in. at \$
 Union in. at \$
 Meter in. at \$
 Cu. Yds. Br. Stone at \$
 Cu. Yds. Sand at \$
 Bags Cement at \$
 Paving Brick { Mack
 Red
 Asphalt } at \$
 3 Hrs. Foreman at \$
 10 Hrs. Common Labor at \$
 Hrs. Mason at \$
 Hrs. at \$
 Hrs. at \$
 Hrs. at \$
 Builders' Use of Water at \$
 Truck 100 at \$
 at \$
 at \$
 at \$
 Total °

LABOR AND MATERIALS

3/4" Copper } Connection _____ \$
 Lead }
 1 Curb } Cock } _____ in. \$
 Valve }
 T.S. & V. }
 1 Service box (Short 3 1/2 x 4 1/2) _____ \$
 Old returned (Long 4-1/2 x 5-1/2)
 24 Ft. 1 in. Copper } Pipe at _____ \$
 G.I. }
 Nipples _____ in. at _____ \$
 1 Bushings 1" to 1/2" in. at _____ \$
 Red'g _____
 Inc'g _____
 Union _____ in. at _____ \$
 Meter _____ in. at _____ \$
 _____ \$
 Compound Joints at _____ \$
 Maintenance Foreman _____ \$
 Hrs. Water Maint. Man - 1 at _____ \$
 Hrs. Water Maint. Man - 2 at _____ \$
 Hrs. Garage Foreman _____ at _____ \$
 Hrs. Labor _____ at _____ \$
 Hrs. Compressor at _____ \$
 _____ \$
 _____ \$
 Trucking _____ \$
 Pav't Patch _____ \$
 _____ \$
 _____ \$
