

LABOR AND MATERIALS


1	Copper Lead	Connection	3/4"	\$
1	Curb	Cock Valve T.S. & V.	3/4" in. O-r-seal	\$
1	Service box Old returned	Short 3 1/2 x 4 1/2 Long 4 1/2 x 5 1/2 Buff or Rdway		\$
9	Ft. 3/4 in.	Copper G.I. C.I.	Pipe at	\$
1	Nipples	in. at		\$
	Bushings	to in. at		\$ at
1	Red'g Inc'g	Coupl'gs 1" to 3/4 in.		\$ at curb
	Union	in. at		\$
	Meter	in. at		\$
	Lead Joints at			\$
	Compound Joints at			\$
	Maintenance Foreman			\$
	Hrs. Water Maint. Man-1	at		\$
	Hrs. Water Maint. Man-2	at		\$
	Hrs. Garage Foreman	at		\$
	Hrs. Labor	at		\$
	Hrs. Compressor at			\$
	Compensation Ins. at \$	per C		\$
	Trucking			\$
	Pav't Patch			\$
	Tap by Harrou + Co.			\$
	O'head			\$

St. Pl. Ave. No. 42

Shepherd

Name of Owner Tapt.

Labor and Mat'l. Report June 10 1965

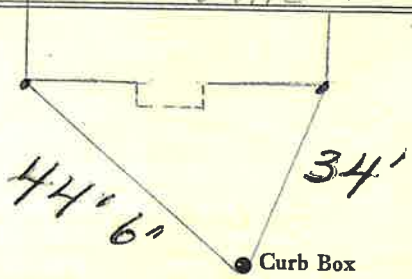

6" Main

Elev. of Main at tap 5"

Gate at • Gate at •

TAX ID # 302.20-19-3

• Curb Box

9' to main
3/4" Copper