

LABOR AND MATERIALS

1	Copper Lead	Connection		\$ 1.23
1	Curb	{ Cock Valve T. S. & V. }	in.	\$ 1.68
	Service Box	{ Short 3 1/2 x 4 1/2 Long 4 1/2 x 5 1/2 Buff. or Rdway }		\$ 1.75
	Old returned			
9	Ft.	{ Copper Galv. Iron Cast Iron }	Pipe at	\$ 1.35
	Nipples	in. at		\$
1	Bushings	to	in. at	\$.64
	Red'g Inc'g	{ Couplings	to in. at	\$
	Union	in. at		\$
	Meter	in. at		\$
	Lead Joints	at		\$
	Leadite Joints	at		\$
	Hrs. Foreman	at		\$
6	Hrs. Chauffeur	at	6 2 1/2	\$ 3.75
	Hrs. Tapper	at		\$
6	Hrs. Labor	at	45	\$ 2.70
	Hrs. Labor	at		\$
2	Hrs. Compressor	at	8 1/2	\$ 1.75
	Compensation Ins.			\$.20
	Trucking			\$ 1.00
	Builders Use of Water	patch		\$ 9.00
	Tap by Miller			\$
				\$
				\$
				\$ 24.45

101 - 1900

St.

Pl.


Ave. No. 44

Name of Owner

Labor and Mat'l. Report

8/26-38

19

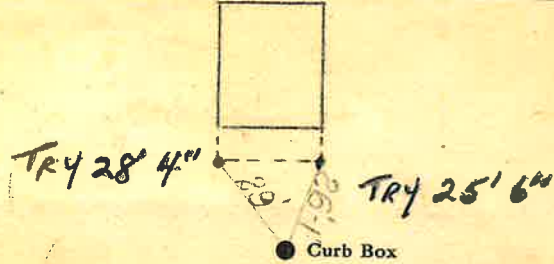

6" Main

Elev. of Main at tap 5'

Gate at ●

● Gate at

TAX ID # 302.20-19-4

● Curb Box

9' to MAIN
3/4" COPPER