

Sherman

St.

Pl.


Ave. No. 7

Name of Owner

Sherman Co.

Labor and Mat'l. Report

Aug 19 87

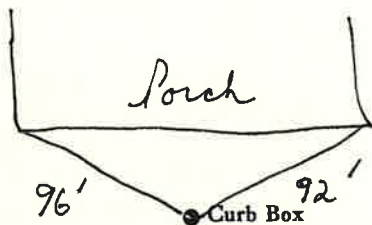

Main

Elev. of

Main at tap

Gate at

#5-7-9

Gate at

TAX ID # 302.20-15-16

Curb Box


24' to main
3/4" copper

LSM-5C-6-1-67

Labor and Material Report

1923

1" tap at 5 Sherman Ave

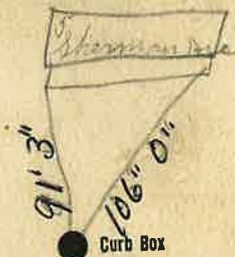

6" Main

Elev. of
Main at tap

Gate at

Gate at

Curb Box

21' to main

1/2" GAL.

#5-7-9

TAX ID # 302.20-15-16

LABOR AND MATERIALS

Copper	}	Connection	_____	\$ _____
Lead				
Curb	}	Cock	_____ in.	\$ _____
		Valve		
		T. S. & V.		
Service box	}	Short 3½ x 4½	_____	\$ _____
Old returned		Long 4½ x 5½		
		Buff or Rdway		
24 Ft. 1½ in.	}	Copper	Pipe at _____	\$ _____
		G.I.		
		G.I.		
Nipples	_____ in. at _____	\$ _____		
Bushings	_____ to _____ in. at _____	\$ _____		
Red'g	}	Coupl'gs	_____ to _____ in. at _____	\$ _____
Inc'g				
Union	_____ in. at _____	\$ _____		
Meter	_____ in. at _____	\$ _____		
Lead Joints	_____ at _____	\$ _____		
Compound Joints	_____ at _____	\$ _____		
Maintenance Foreman	_____	\$ _____		
Hrs. Water Maint. Man	—1 at _____	\$ _____		
Hrs. Water Maint. Man	—2 at _____	\$ _____		
Hrs. Garage Foreman	_____ at _____	\$ _____		
Hrs. Labor	_____ at _____	\$ _____		
Hrs. Compressor	_____ at _____	\$ _____		
Compensation Ins.	at \$ _____ per C	\$ _____		
Trucking	_____	\$ _____		
Pav't Patch	_____	\$ _____		
	_____	\$ _____		
	_____	\$ _____		
	_____	\$ _____		
O'head	_____	\$ _____		
	_____	\$ _____		

Labor and Materials


1	Lead Connection	_____	\$ _____
1	Curb Cock	1 1/4 Valve	\$ _____
1	Service Box	Short 3 1/2 x 4 1/2	\$ _____
	Old returned	Long 4 1/2 x 5 1/2	
21	Ft. 1 1/2 in. G. I. Pipe	at _____	\$ _____
	Nipples	_____ in. at _____	\$ _____
	Bushings	_____ in. at _____	\$ _____
	Red'g Coup	_____ to _____ in. at _____	\$ _____
	Inc'g Coup	_____ to _____ in. at _____	\$ _____
	Union	_____ in. at _____	\$ _____
	Meter	_____ in. at _____	\$ _____
	Cu. Yds. Br. Stone	at _____	\$ _____
	Cu. Yds. Sand	at _____	\$ _____
	Bags Cement	at _____	\$ _____
	Pav. Brick	{ Mack Red Asphalt } at _____	\$ _____
3	Hrs. Foreman	at _____	\$ _____
12	Hrs. Com. Labor	at _____	\$ _____
	Hrs. Mason	at _____	\$ _____
	Hrs.	_____ at _____	\$ _____
	Hrs.	_____ at _____	\$ _____
	Builders' Use of Water	_____ at _____	\$ _____
	Trucks	150 _____ at _____	\$ _____
	Digging up old	_____ at _____	\$ _____
	Construction	4 h. I. F. _____ at _____	\$ _____
	Half to be charge for	_____	\$ _____
	7 Sherman Ave	_____	\$ _____
		total	\$ 20.87

Labor and Materials

1	Lead Connection ^{3/4}	\$
1	Curb Cock	\$
1	Service Box (Short 3 1/2 x 4 1/2)	\$
	Old returned (Long 4 1/2 x 5 1/2)	\$
	Buffalo	\$
21	Ft. 1" in. G. I. Pipe at	\$
	Nipples . . . in. at	\$
	Bushings . . . in. at	\$
	Red'g Coup . . . to . . . in. at	\$
	Inc'g Coup . . . to . . . in. at	\$
	Union . . . in. at	\$
	Meter . . . in. at	\$
	Cu. Yds. Br. Stone at	\$
	Cu. Yds. Sand at	\$
	Bags Cement at	\$
	Pav. Brick { Mack Red Asphalt } at	\$
2	Hrs. Foreman at	\$
10	Hrs. Com. Labor at	\$
	Hrs. Mason at	\$
	Hrs. at	\$
	Hrs. at	\$
90	Builders' Use of Water	\$
	at	\$
	7.000k. 1.00	\$
	at	\$
	at	\$
	at	\$
	Total	\$ 14.58

Labor and Material Report ^{Aug 11} 1923

3/4" tap at 9411 Sherman Ave

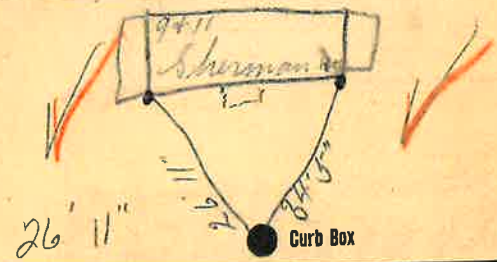

6 Main Elev. of Main at tap 5 1/2
 Gate at ● Gate at ●

● Curb Box

21' to main
 1" GAK
 #5-7-9
 TAX ID# 302.20-15-16