


LABOR AND MATERIALS

1	Copper	} Connection	3/4"	\$
1	Lead			
1	Curb	} Cock Valve T.S. & V.	3/4 in.	\$
1	Service box		} Short 3 1/2 x 4 1/2	
Old returned				Long 4 1/2 x 5 1/2
			Buff or Rdway	\$
24	Ft. 3/4 in.	} Copper G.I. G.I.	Pipe at	\$
	Nipples	in. at		\$
	Bushings	to in. at		\$
	Red'g } Inc'g }	Coupl'gs	to in. at	\$
	Union	in. at		\$
	Meter	in. at		\$
	Lead Joints	at		\$
	Compound Joints	at		\$
	Maintenance Foreman			\$
	Hrs. Water Maint. Man-1	at		\$
	Hrs. Water Maint. Man-2	at		\$
	Hrs. Garage Foreman	at		\$
	Hrs. Labor	at		\$
	Hrs. Compressor	at		\$
	Compensation Ins.	at \$ per C		\$
	Trucking			\$
	Pav't Patch			\$
	Tap by Gifford & Co.			\$
				\$
				\$
	O'head			\$
				\$

Sherman Ave. No. 47

Name of Owner Harry Gutheil

Labor and Mat'l. Report Oct. 18 1967

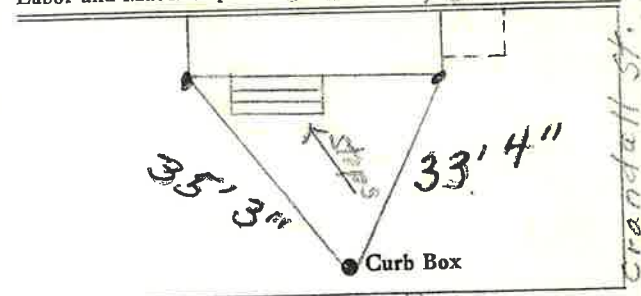

Sherman Ave.
6 Main Elev. of Main at tap 5 1/2

Gate at • Gate at •
TAX ID # 302.19-28-33

• Curb Box
Tap on Sherman Ave.
24' to main
3/4" copper