


Labor and Materials

1	Lead Connection <i>3/4</i>\$
1	Curb Cock <i>3/4</i>\$
1	Service Box <i>OSP</i> { Short $3\frac{1}{2}$ x $4\frac{1}{2}$ Old returned { Long $4\frac{1}{2}$ x $5\frac{1}{2}$ Buffalo\$
8	Ft. <i>3/4</i> in. G. I. Pipe at <i>OSP</i>\$
	Nipples..... in. at.....\$
X	Bushings..... to..... in. at.....\$
	Red'g Coup..... to..... in. at.....\$
	Inc'g Coup..... to..... in. at.....\$
	Union..... in. at.....\$
	Meter..... in. at.....\$
	Cu. Yds. Br. Stone at.....\$
	Cu. Yds. Sand at.....\$
	Bags Cement at.....\$
	Paving Brick { Mack Red Asphalt } at.....\$
1 1/2	Hrs. Foreman at.....\$
9 1/2	Hrs. Common Labor at.....\$
	Hrs. Mason at.....\$
	Hrs..... at.....\$
	Hrs..... at.....\$
	Builders' Use of Water.....\$
 at.....\$
 at.....\$
 at.....\$
 at.....\$
Total		\$ 11.87

Labor and Material Report 1925

48850 *Herman*

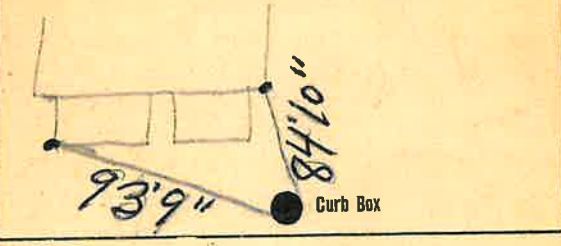

Main Elev. of
Main at tap Gate at

Gate at #48 TAX ID # 302.20-19-10 Gate at

