


Labor and Materials

1 Cop. Lead Connection	\$
1 Curb Cock	\$
Service Box (Short 8 1/2 x 4 1/2)	\$
Old returned (Long 4 1/2 x 6 1/2)	\$
25 Ft. 3/4 in. G. I. Pipe at	\$
Nipples in. at	\$
Bushings 1/2 to 3/4 in. at	\$
Red'g Coup. to in. at	\$
Inc'g Coup. to in. at	\$
Union in. at	\$
Meter in. at	\$
Cu. Yds. Br. Stone at	\$
Cu. Yds. Sand at	\$
Bags Cement at	\$
Paving Brick { Mack Red Asphalt } at	\$
2 1/2 Hrs. Foreman at	\$
12 Hrs. Common Labor at	\$
Hrs. Mason at	\$
Hrs. at	\$
Hrs. at	\$
No Builders' Use of Water	\$
Truck	\$
at	\$
at	\$
at	\$
Total	\$ 19.72

51 Sherman Ave.

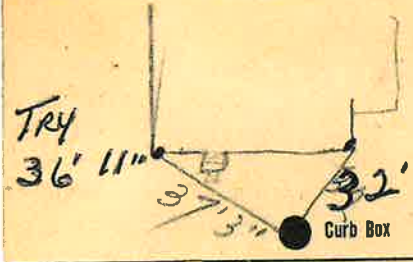

Main Elev. of Main at tap

Gate at ● TAX ID # 302.19-28-31 ● Gate at

