


Labor and Materials

1	Lead Connection	2.69
1	Curb Cock	1.76
1	Service Box (Short 3" x 4" Long 12" x 5")	1.29
7	Old returned (Buffalo)	
	Ft. 1/2 in. G. I. Pipe at	1.37
	Nipples.....in. at	\$
	Bushings.....to.....in. at	\$
	Red'g Coup.....to.....in. at	\$
	Inc'g Coup.....to.....in. at	\$
	Union.....in. at	\$
	Meter.....in. at	\$
	Cu. Yds. Br. Stone at	\$
	Cu. Yds. Sand at	\$
	Bags Cement at	\$
	Paving Brick { Mack Red Asphalt } at	\$
2	Hrs. Foreman at	1.25
2	Hrs. Common Labor at	.81
	Hrs. Mason at	\$
	Hrs.....at	\$
	Hrs.....at	\$
1	Builders' Use of Water	1.50
1	truck	1.00
	Comp. Ins	.05
	at	\$
	at	\$
	at	\$
	Total	11.72

Oct 11
52-8 Wernway Ave.

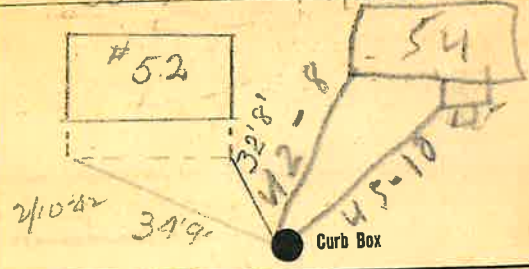

6 Main Elev. of Main at tap 4 1/2

Gate at TAX ID # 302.20-19-7 Gate at

Curb Box

measured in from 54
7' to main
1" gate.