


LABOR AND MATERIALS

1	Copper	} Connection $\frac{3}{4}$ "	\$
1	Lead		\$
1	Curb	} Cock Valve T. S. & V. } $\frac{3}{4}$ in.	\$
1	Service box Old returned		} Short $3\frac{1}{2} \times 4\frac{1}{2}$ Long $4\frac{1}{2} \times 5\frac{1}{2}$ Buff or Rdway
26	Ft. $\frac{3}{4}$ in.	} Copper G.I. G.I.	
	Nipples		in. at \$
	Bushings	to in. at \$	
	Red'g } Inc'g }	Coupl'gs to in. at \$	
	Union	in. at \$	
	Meter	in. at \$	
	Lead Joints	at \$	
	Compound Joints	at \$	
	Maintenance Foreman	\$	
	Hrs. Water Maint. Man-1	at \$	
	Hrs. Water Maint. Man-2	at \$	
	Hrs. Garage Foreman	at \$	
	Hrs. Labor	at \$	
	Hrs. Compressor	at \$	
	Compensation Ins. at \$	per C. \$	
	Trucking	\$	
	Pav't Patch	\$	
	Tap by Giesbard & Co		\$
	8-24-61		\$
	O'head	\$	
		\$	

St. Sherman  
Pl. 53  
Ave. No. 53

Name of Owner  
Mrs. S.B. Cleveland

Labor and Mat'l. Report Aug 24 1961

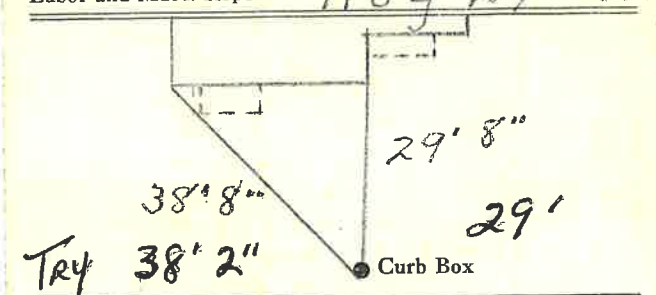

6" Main Elev. of Main at tap 4 1/2

Gate at • Gate at

TAX ID # 302.19-28-30

• Curb Box

26' to MAIN  
 $\frac{3}{4}$ " Copper