

LABOR AND MATERIALS


1	Copper Lead	Connection	3/4"	\$	_____
1	Curb Valve	Cock T.S. & V.	3/4" in.	\$	_____
1	Service box	Short 3 1/2 x 4 1/2		\$	_____
1	Old returned	Long 4 1/2 x 5 1/2		\$	_____
		Buff or Rdway		\$	_____
10	Ft. 3/4" in.	Copper C.I. C.I.	Pipe at	\$	_____
	Nipples	in. at		\$	_____
	Bushings	to in. at		\$	_____
	Red'g Inc'g	Coupl'gs to in. at		\$	_____
	Union	in. at		\$	_____
	Meter	in. at		\$	_____
	Lead Joints at			\$	_____
	Compound Joints at			\$	_____
	Maintenance Foreman			\$	_____
	Hrs. Water Maint. Man-1	at		\$	_____
1	Hrs. Water Maint. Man-2	at		\$	_____
	Hrs. Garage Foreman	at		\$	_____
	Hrs. Labor	at		\$	_____
	Hrs. Compressor at			\$	_____
	Compensation Ins. at \$	per C		\$	_____
	Trucking			\$	_____
	Pav't Patch			\$	_____
	Tap by bareo v			\$	_____
	Tap by Doman			\$	_____
				\$	_____
	O'head			\$	_____
				\$	_____

Tap by bareo v
Tap by Doman
6-6-63

St. _____
Pl. _____
Ave. No. 54

Name of Owner
K. A. Taylor

Labor and Mat'l. Report June 6 1963

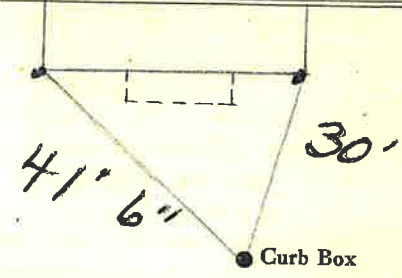

6" C.I. Main Elev. of Main at tap 4'

Gate at • Gate at

TAX ID # 302.20-19-8

10' to main
3/4" copper