


Labor and Material Report Aug 11 1923

1/2" tap at 8 Sherman Ave

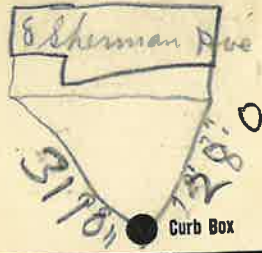

6" Main

Elev. of Main at tap 5'11"

Gate at ●

● Gate at

● Curb Box

9' to main  
3/4" GAL.


Sherman

~~St.~~  
~~#~~  
Ave. No. 8

Name of Owner

Edna Rouney

Labor and Mat'l. Report Dec 8 1977

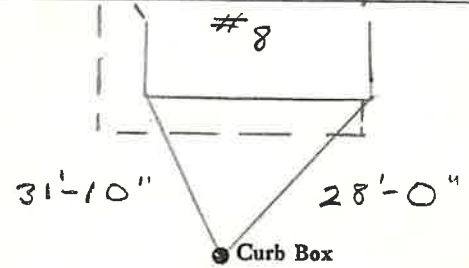

6" Main

Elev. of Main at tap 5'

Gate at ●

● Gate at

TAX ID # 302.20-21-4

● Curb Box

9' to main  
3/4" copper

LSM-5C-6-1-67

OKV

**Labor and Materials**

1	Lead Connection <sup>1/2"</sup>	\$
1	Curb Cock <sup>3/4"</sup>	\$
1	Service Box { Short 3 1/2 x 4 1/2 Old returned { Long 4 1/2 x 5 1/2 Buffalo	\$
9	Ft. 3/4 in. G. I. Pipe at	\$
	Nipples.....in. at	\$
	Bushings.....in. at	\$
	Red'g Coup... to...in. at	\$
	Inc'g Coup... to...in. at	\$
	Union.....in. at	\$
	Meter.....in. at	\$
	Cu. Yds. Br. Stone at	\$
	Cu. Yds. Sand at	\$
	Bags Cement at	\$
	Pav. Brick { Mack Red } at	\$
2	Hrs. Foreman at	\$
8	Hrs. Com. Labor at	\$
	Hrs. Mason at	\$
	Hrs. ....at	\$
	Hrs. ....at	\$
20	Builders' Use of Water	\$
	at	\$
	at	\$
	Truck 100	\$
	at	\$
	at	\$
	Total . \$	9.65

**LABOR AND MATERIALS**

1	Copper Lead } Connection <sup>3/4</sup>	\$
1	Curb } Cock Valve- T.S. & V. } <sup>3/4</sup> in.	\$
1	Service box } Short 3 1/2 x 4 1/2 Old returned { Long 4 1/2 x 5 1/2 Buff or Rdway }	\$
9	Ft. 3/4 in. { Copper C.I. } Pipe at	\$
	Nipples.....in. at	\$
	Bushings.....to.....in. at	\$
	Red'g } Coupl'gs.....to.....in. at	\$
	Inc'g }	\$
	Union.....in. at	\$
	Meter.....in. at	\$
	Lead Joints at	\$
	Compound Joints at	\$
	Maintenance Foreman	\$
	Hrs. Water Maint. Man-1 at	\$
	Hrs. Water Maint. Man-2 at	\$
	Hrs. Garage Foreman.....at	\$
	Hrs. Labor.....at	\$
	Hrs. Compressor at	\$
	Compensation Ins. at \$.....per C	\$
	Trucking	\$
	Pav't Patch	\$
	Top by St Jakob Co	\$
	Dec 8, 1978	\$
		\$
	O'head	\$
		\$