


LABOR AND MATERIALS

1 Copper } Connection $\frac{3}{4}$ " \$
 Lead }
 1 Curb } Cock } $\frac{3}{4}$ " Oriseal \$
 } Valve }
 } F.S. & V. }
 1 Service box { Short $3\frac{1}{2}$ x $4\frac{1}{2}$ }
 Old returned { Long $4\frac{1}{2}$ x $5\frac{1}{2}$ }
 } Buff. or Rdway } \$
 24 Ft. $\frac{3}{4}$ in. { Copper } Pipe at \$
 } G.I. }
 } G.I. }
 Nipples in. at \$
 Bushings to in. at \$
 Red'g }
 Inc'g } Coupl'gs to in. at \$
 Union in. at \$
 Meter in. at \$
 Lead Joints at \$
 Compound Joints at \$
 Maintenance Foreman \$
 Hrs. Water Maint. Man-1 at \$
 Hrs. Water Maint. Man-2 at \$
 Hrs. Garage Foreman at \$
 Hrs. Labor at \$
 Hrs. Compressor at \$
 Compensation Ins. at \$ per C \$
 Trucking \$
 Pav't Patch \$
 Tap by Giggard & Co. \$
 11-9-64. \$
 O'head \$

St. _____
 Pl. _____
 Ave. No. 61

Sherman
 Name of Owner
 Beatrice C. Connell

Labor and Mat'l. Report Nov. 9 1964.

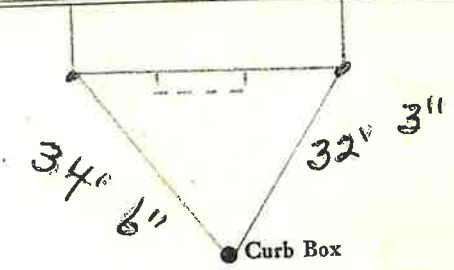

6" Main Elev. of Main at tap $4\frac{1}{2}$ '

Gate at • Gate at
 TAX ID # 302,19-28-26

24' to MAIN • Curb Box
 $\frac{3}{4}$ " Copper