


Labor and Materials		
^{cop} Lead Connection ^{3/4"}		\$.
1 Curb Cock ^{3/4"}		\$.
1 Service Box { Short 3" x 4"		\$.
Old returned { Long 4" x 5"		
9 Ft. ^{3/4"} in. G. I. Pipe at ^{cop}		\$.
Nipples.....in. at.....		\$.
X Bushings.....to.....in. at.....		\$.
Red'g Coup....to....in. at.....		\$.
Inc'g Coup....to....in. at.....		\$.
Union.....in. at.....		\$.
Meter.....in. at.....		\$.
.....Cu. Yds. Br. Stone at.....		\$.
.....Cu. Yds. Sand at.....		\$.
.....Bags Cement at.....		\$.
.....Paving Brick { Mack Red Asphalt } at.....		\$.
^{1 1/2} Hrs. Foreman at.....		\$.
^{10 1/2} Hrs. Common Labor at.....		\$.
Hrs. Mason at.....		\$.
Hrs.....at.....		\$.
Hrs.....at.....		\$.
.....Builders' Use of Water.....		\$.
.....at.....		\$.
.....at.....		\$.
Total	\$ 12.61	

66 Sherman Ave.

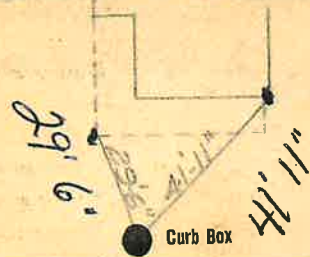

9' Main Elev. of Main at tap

Gate at Gate at

TAX ID# 309.7-9-9

