

Labor and Material Report

68-70 19

Lot 70 Sherman Ave  
House 72 Sherman Ave



Main

Elev. of Main at tap

Gate at


Gate at

● Curb Box  
 Lot 70 curb box  
 Dug up. Alive to  
 Curb,  
 10' to MAIN

Labor and Material Report

68+70 19

Lot 6 Sherman Ave

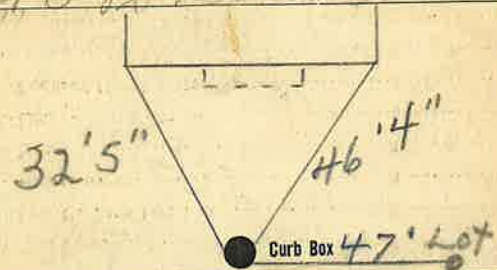

Lot 70 curb box  
 Dug up 10-6-54 alive to  
 Main Elev. of Main at tap Curb.

Gate at

#68 TAX ID# 309.7-9-10

Gate at

● Curb Box  
 10' to MAIN

