


Labor and Material Report

Dec 27

1/2" tap at 69 Harmon Ave

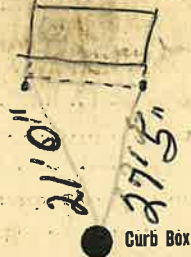

6" Main

Elev. of Main at tap 4'

Gate at ●

● Gate at

● Curb Box

30' to main

3/4" GPH

TURN OFF
1/25/13

Shremm

St.

Pl.


Ave. No.

69

Name of Owner

Labor and Mat'l. Report 19

1/25/13

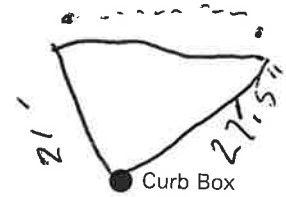

6" Main

Elev. of Main at tap 5'

Gate at ●

● Gate at

● Curb Box

TAX ID# 302.19-28-23

new water line
3/4 copper

Labor and Materials

1. Lead Connection \$
 1. Curb Cock \$
 Service Box (Short 3 1/2 x 4 1/2) \$
 Old returned (Long 4 1/2 x 5 1/2) \$
 Buffalo
 20 Ft. in. G. I. Pipe at \$
 Nipples in. at \$
 Bushings to in. at \$
 Red'g Coup to in. at \$
 Inc'g Coup to in. at \$
 Union in. at \$
 Meter in. at \$
 Cu. Yds. Br. Stone at \$
 Cu. Yds. Sand at \$
 Bags Cement at \$
 Paving Brick (Mack Red Asphalt) at \$
 2 Hrs. Foreman at \$
 7 Hrs. Common Labor at \$
 Hrs. Mason at \$
 Hrs. at \$
 Hrs. at \$
 Builders' Use of Water \$
 Truck 100 at \$
 at \$
 at \$
 Total \$ 14.00

LABOR AND MATERIALS

3/4 Copper } Connection \$
 Lead }
 Curb } Cock } in. \$
 } Valve }
 } T.S. & V. }
 Service box { Short 3-1/2 x 4-1/2 } \$
 Old returned { Long 4-1/2 x 5-1/2 }
 30 Ft. 1 in. { Copper } Pipe at \$
 } G.I. }
 } C.I. }
 Nipples in. at \$
 Bushings to in. at \$
 Red'g 1/25/13
 Inc'g
 Union in. at \$
 Meter in. at \$
 \$
 Compound Joints at \$
 Maintenance Foreman \$
 Hrs. Water Maint. Man - 1 at \$
 Hrs. Water Maint. Man - 2 at \$
 Hrs. Garage Foreman at \$
 Hrs. Labor at \$
 Hrs. Compressor at \$
 \$
 Trucking \$
 Pav't Patch \$
 \$
 \$
