


Labor and Materials

Lead Connection <sup>cap</sup>		\$
1. Curb Cock <sup>3/4</sup>		\$
1. Service Box (Short 3 1/2 x 4 1/2)		\$
Old returned <sup>5'</sup>		\$
9. Ft. <sup>3/4</sup> in. G. I. Pipe at <sup>cap</sup>		\$
Nipples.....in. at		\$
X. Bushings .....to.....in. at		\$
Red'g Coup.....to.....in. at		\$
Inc'g Coup.....to.....in. at		\$
Union.....in. at		\$
Meter.....in. at		\$
Cu. Yds. Br. Stone at		\$
Cu. Yds. Sand at		\$
Bags Cement at		\$
Paving Brick { Mack Red Asphalt } at		\$
1/2 Hrs. Foreman at		\$
8 1/2 Hrs. Common Labor at		\$
Hrs. Mason at		\$
Hrs.....at		\$
Hrs.....at		\$
Builders' Use of Water		\$
.....at		\$
.....at		\$
Total	\$ 11.78	

74 Sherman Ave.

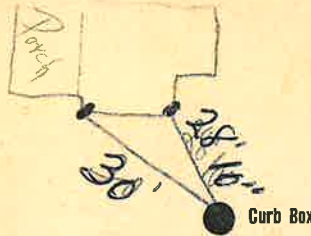

TAX ID# 309.7-8-10

Main

Elev. of Main at tap

Gate at

Gate at

9' to main  
3/4" copper

Curb Box

