


Labor and Materials

1 1 Connection ^{3/4}	\$
1 Curb Cock..... ^{3/4}	\$
1 Service Box (Short 3 1/2 x 4 1/2 Old returned (1 1/2 x 3 1/2 Buffalo	\$
28 ^{3/4} Ft. ^{3/4} in. G. I. Pipe at ^{cof.}	\$
..... Nipples..... in. at	\$
..... Bushings to..... in. at	\$
1 Red'g Coup..... to ^{3/4} in. at	\$
..... Inc'g Coup..... to..... in. at	\$
..... Union..... in. at	\$
..... Meter..... in. at	\$
..... Cu. Yds. Br. Stone at	\$
..... Cu. Yds. Sand at	\$
..... Bags Cement at	\$
Paving Brick (Mack Red Asphalt) at	\$
^{2 1/2} Hrs. Foreman at	\$
19 Hrs. Common Labor at	\$
Hrs. Mason at	\$
Hrs. at	\$
Hrs. at	\$
ND. Builders' Use of Water	\$
..... at	\$
..... at	\$
..... at	\$
..... at	\$
Total \$ <u>20.89</u>	

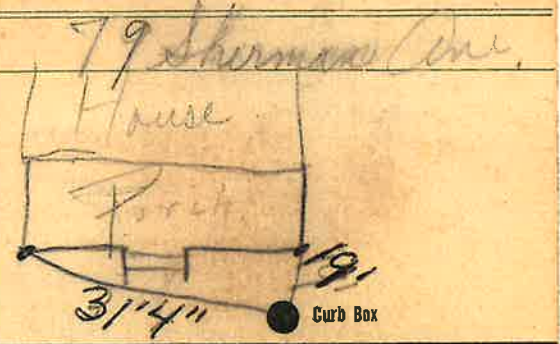

TAX ID# 302.19-27-10

Main Elev. of
Main at tap

Gate at ● ● Gate at

28' to main
3/4" copper

