

LABOR AND MATERIALS

1 Copper Lead	{ Connection } 3/4	\$
1 Curb	{ Cock Valve T. S. & V. } 3/4 in.	\$
Service box - Old returned	{ Short 3 1/2 x 4 1/2 Long 4 1/2 x 5 1/2 Buff or Rwyway }	\$
28 Ft. in.	{ Copper C.I. } Pipe at	\$
Nipples	in. at	\$
Bushings	to in. at	\$
Red'g Inc'g	{ Coupl'gs } to in. at	\$
Union	in. at	\$
Meter	in. at	\$
Lead Joints at		\$
Compound Joints at		\$
2 1/4 Maintenance Foreman		\$
Hrs. Water Maint. Man-1	at	\$
Hrs. Water Maint. Man-2	at	\$
Hrs. Garage Foreman	at	\$
19 1/2 Hrs. Labor	at	\$
Hrs. Compressor at		\$
Compensation Ins. at \$	per C.	\$
Trucking		\$
Pav't Patch		\$
No Bldg use of water		\$
O'head		\$
		\$ 22.54

Sherman Ave. No. 81  
 St. Pl. Ave. No. 81


Name of Owner

O'CONNOR

Located box 7-1-54

Labor and Mat'l. Report

19

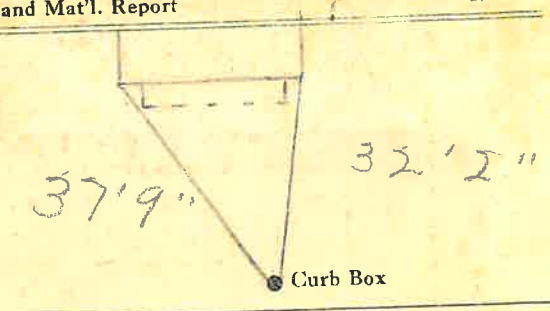

6' Main      Elev. of Main at tap 5''

Gate at      Gate at

28' to MAIN

3/4" copper      Curb Box

TAX ID# 302.19-27-9