


Labor and Materials

Lead Connection ^{3/4}	\$.....
Curb Cock ^{3/4}	\$.....
Service Box (Short 3 1/2 x 4) Old returned Long 4 x 6 Buffalo	\$.....
7 Ft. ^{3/4} in. Gal. Pipe at.....	\$.....
Nipples..... in. at.....	\$.....
Bushings..... to..... in. at.....	\$.....
Red'g Coup..... to..... in. at.....	\$.....
Inc'g Coup..... to..... in. at.....	\$.....
Union..... in. at.....	\$.....
Meter..... in. at.....	\$.....
Cu. Yds. Br. Stone at.....	\$.....
Cu. Yds. Sand at.....	\$.....
Bags Cement at.....	\$.....
Paving Brick { Mack Red Asphalt } at.....	\$.....
^{1 1/2} Hrs. Foreman at.....	\$.....
^{6 1/2} Hrs. Common Labor at.....	\$.....
Hrs. Mason at.....	\$.....
Hrs..... at.....	\$.....
Hrs..... at.....	\$.....
Builders' Use of Water.....	\$.....
..... at.....	\$.....
..... at.....	\$.....
..... at.....	\$.....
..... at.....	\$.....
Total \$ <u>11.63</u>	

Labor and Material Report

Lot 84 Sherman Ave

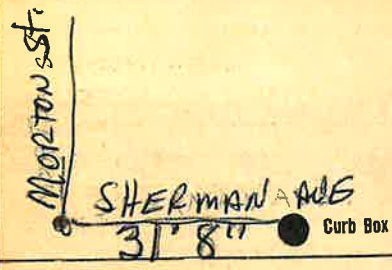

Main Elev. of Main at tap

Gate at Gate at

*2' to main
3/4" copper*

