


LABOR AND MATERIALS

1	Copper	} Connection	3/4"	\$	
1	Lead			\$	
1	Curb	} Cock Valve T.S. & V.	3/4 in. Oriseal	\$	
1	Service box		} Short 3 1/2 x 4 1/2		
Old returned				Long 4 1/2 x 5 1/2	
			Buff. or Rdway	\$	
10	Ft.	} Copper	3/4 in.	} Pipe at \$	
					G.I.
					G.I.
	Nipples	in. at		\$	
	Bushings	to in. at		\$	
	Red'g	} Coupl'gs	to in. at	\$	
	Inc'g				
	Union	in. at		\$	
	Meter	in. at		\$	
	Lead Joints	at		\$	
	Compound Joints	at		\$	
	Maintenance Foreman			\$	
	Hrs. Water Maint. Man-1	at		\$	
	Hrs. Water Maint. Man-2	at		\$	
	Hrs. Garage Foreman	at		\$	
	Hrs. Labor	at		\$	
	Hrs. Compressor	at		\$	
	Compensation Ins. at \$	per C		\$	
	Trucking			\$	
	Pav't Patch			\$	
	Tap by Gifford & Co.			\$	
	11-15-67.			\$	
	O'head			\$	

St. Sherman  
 Pl. 89  
 Ave. No. 89

Name of Owner  
Mary Leesari.

Labor and Mat'l. Report Nov. 15 1967

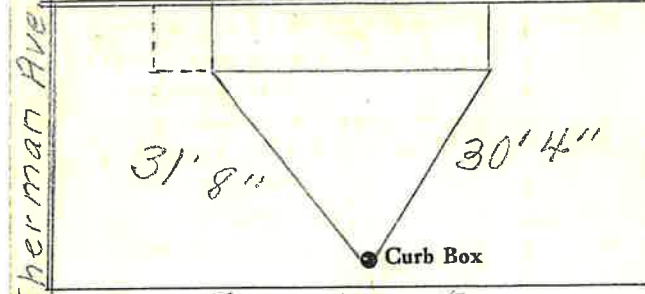

Empire Ave.  
 6" Main Elev. of Main at tap 4'

Gate at • 10' to MAIN  
 • Gate at 3/4" copper

• Curb Box  
 Tap ON Empire Ave.  
 TAX ID# 302.19-26-10