


Labor and Materials

1	Lead Connection		\$ 3.25
1	Curb Cock		\$ 1.50
1	Service Box	{ Short 3 1/2 x 4 1/2	\$ 1.33
	Old returned	{ Long 4 1/2 x 5 1/2	
		{ Buffalo	
2	3/4" in. G. I. Pipe at	supper	\$ 1.54
	Nipples	in. at	\$
	Bushings	to in. at	\$
1	Red'g Coup	to in. at	\$ 1.5
	Inc'g Coup	to in. at	\$
	Union	in. at	\$
	Meter	in. at	\$
	Cu. Yds. Br. Stone at		\$
	Cu. Yds. Sand at		\$
	Bags Cement at		\$
	Paving Brick	{ Mack	\$
		{ Red	\$
		{ Asphalt	\$
2	Hrs. Foreman at		\$ 1.25
2	Hrs. Common Labor at		\$ .91
	Hrs. Mason at		\$
	Hrs.	at	\$
	Hrs.	at	\$
1/2	Builders' Use of Water		\$ 1.50
		at	\$
	Tools	at	\$ 1.00
	2ma.	at	\$ .05
		at	\$
	Total		\$ 10.35

90 Sherman Ave.

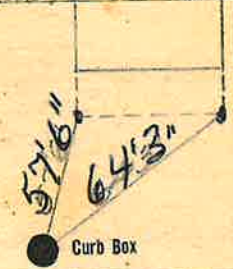

6" Main Elev. of Main at tap 4 1/2

Gate at 7' to MAIN 3/4" COPPER Gate at Curb Box