


Labor and Materials

1	Lead Connection	1/2	\$
1	Curb Cock		\$
1	Service Box	Short 3 1/2 x 4 1/2	\$
	Old returned	Long 4 1/2 x 5 1/2	\$
		Buffalo	\$
28	Ft. 3/4 in. G. I. Pipe at		\$
	Nipples	in. at (CHANGED) to	\$
	Bushings	in. at 3/4" TAP	\$
	Red'g Coup	to in. at	\$
	Inc'g Coup	to in. at 3/4" Copper line	\$
	Union	in. at 3/86	\$
	Meter	in. at	\$
	Cu. Yds. Br. Stone at		\$
	Cu. Yds. Sand at		\$
	Bags Cement at		\$
	Pav. Brick	{ Mack Red Asphalt } at	\$
2	Hrs. Foreman at		\$
2	Hrs. Com. Labor at		\$
	Hrs. Mason at		\$
	Hrs.	at	\$
	Hrs.	at	\$
1/2	Builders' Use of Water	at	\$
	Truck	100 at	\$
		at	\$
		at	\$
		at	\$
	Total	\$ 11.48	

91 Labor and Material Report 9/16 1922

1/2" Top at 9' Sherman

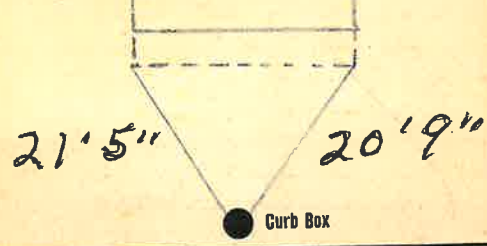

6" Main Elev. of Main at tap 44

Gate at ● Gate at ●

28' to main  
3/4" Copper

● Curb Box

TAX ID# 302.19-26-9