


Labor and Material Report

19

97 Sherman Ave.

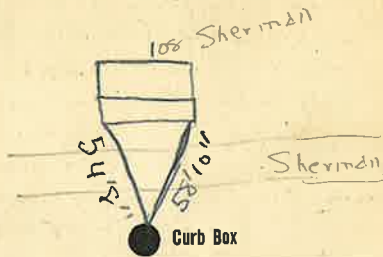

6" Main

Elev. of Main at tap

Gate at ●

● Gate at




St. _____
Pl. _____
Ave. No. 97

Name of Owner _____

Labor and Mat'l. Report

July

1945

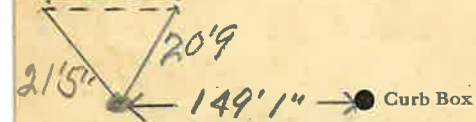

..... Main Elev. of Main at tap.....
Gate at ● ● Gate at

● Curb Box

This lot top is measure from Curb box at #91

LSM-SC-6-1-45

