


Main Elev. of Main at tap \_\_\_\_\_  
 Gate at ● 8' to MAIN ● Gate at



# 106 TAX ID# 309.7-7-8  
 Main Elev. of Main at tap \_\_\_\_\_  
 Gate at ● 8' to MAIN ● Gate at

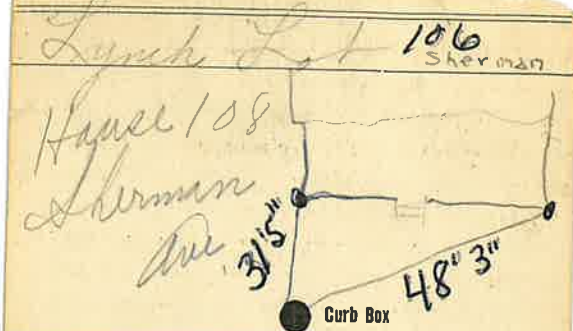