

LABOR AND MATERIALS


1	Copper Lead	Connection	3/4"	\$	308
1	Curb	Cock Valve-T.S. & V.	3/4 in.	\$	3.89
1	Service box Old returned	Short 3 1/2 x 4 1/2 Long 4 1/2 x 5 1/2 Buff or Rdway		\$	4.32
9	Ft. 3/4 in.	Copper G.I. C.I. Pipe at	45	\$	405
	Nipples	in. at		\$	
	Bushings	to in. at		\$	
	Red'g Inc'g	Coupl'gs to in. at		\$	
	Union	in. at		\$	
	Meter	in. at		\$	
	Lead Joints at			\$	
	Compound Joints at			\$	
	Maintenance Foreman			\$	42.13
	Hrs. Water Maint. Man-1 at			\$	
10	Hrs. Water Maint. Man-2 at	1.613		\$	16.13
	Hrs. Garage Foreman at			\$	
20	Hrs. Labor at	1.30		\$	26.00
	Hrs. Compressor at			\$	
	Compensation Ins. at \$	5.686 per C		\$	2.40
	Trucking			\$	1.50
	Pay't Patch			\$	11.20
	Tap by Gifford & Co.			\$	
		8-22-56		\$	
	O'head			\$	
				\$	72.59

6/37

Sherman St. Ave. No. 16

Name of Owner
Brayton

Labor and Mat'l. Report Aug 22 1956

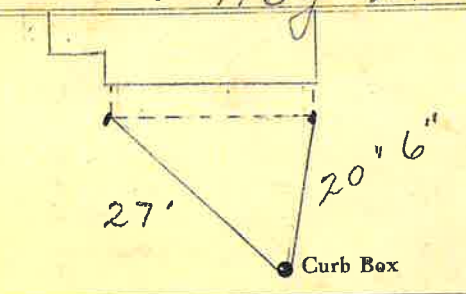

6" Main Elev. of Main at tap 5'

Gate at • Gate at •

TAX ID # 302.20-21-6

• Curb Box
9' to main
3/4" copper