


LABOR AND MATERIALS

1 Copper } Connection $\frac{3}{4}$ " \$
 Lead }
 1 Curb } Cock } $\frac{3}{4}$ in. O-r seal. \$
 Valve }
 T.S. & V. }
 1 Service box } Short $3\frac{1}{2}$ x $4\frac{1}{2}$ \$
 Old returned } Long $4\frac{1}{2}$ x $5\frac{1}{2}$ \$
 } Buff or Rdway }
 30 Ft. $\frac{3}{4}$ in. } Copper } Pipe at \$
 } G.I. }
 } C.I. }
 Nipples in. at \$
 Bushings to in. at \$
 Red'g }
 Inc'g } Coupl'gs to in. at \$
 Union in. at \$
 Meter in. at \$
 Lead Joints at \$
 Compound Joints at \$
 Maintenance Foreman \$
 Hrs. Water Maint. Man-1 at \$
 Hrs. Water Maint. Man-2 at \$
 Hrs. Garage Foreman at \$
 Hrs. Labor at \$
 Hrs. Compressor at \$
 Compensation Ins. at \$ per C \$
 Trucking \$
 Pav't Patch \$
 Tap by Hareau & Co. \$
 Nov. 14-70 \$
 O'head \$

St. _____
 Pl. _____
 Ave. No. 17-19

Name of Owner
 Jack - Marks Realty

Labor and Mat'l. Report Nov. 14 1970.

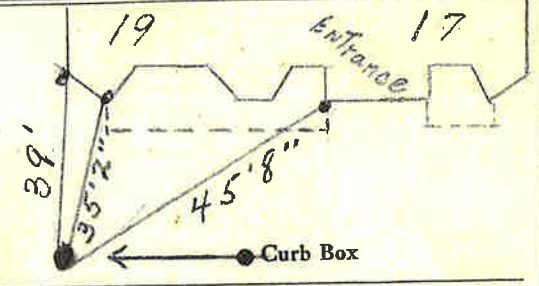

6" Main Elev. of Main at tap 5'
 Gate at • Gate at

TAX ID # 302.20.14.1

• Curb Box
 30' to main
 $\frac{3}{4}$ " copper