

Material Report

19

#124 Sherman Ave.  
House 122  
Sherman Ave.




See Below

FD # 309.7-5-11

Elev. of Main at tap

● Gate at

10' to MAIN  
3/4" Copper

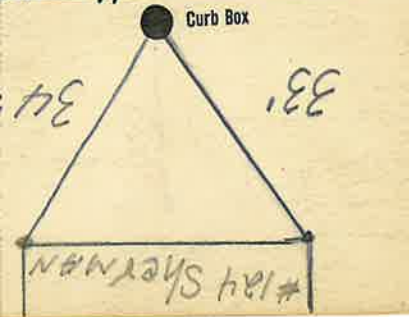


SHERMAN

Str. No. 124

Name of Owner

Labor and Mat'l. Report

1925

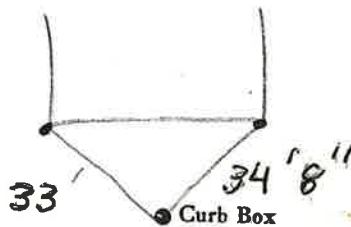

Main

Elev. of Main at tap

Gate at ●

● Gate at

10' to MAIN

● Curb Box

3/4" Gal. pipe

