


Labor and Materials

| | | |
|---------------------------------|--------------------|---------|
| Copper } Connection | | \$ 2.60 |
| Lead } | | |
| Curb { Cock Valve } | in. 3 | \$ 2.30 |
| | T. S. & V. } | |
| Service Box } Short 3/4x4 1/2 } | | \$ 1.40 |
| Old returned } | Long 1 1/2x5 1/2 } | |
| | Buff. or Rdway } | |
| 27 Ft. in. Copper } | Pipe at | \$ 7.16 |
| | Galv. Iron } | |
| | Cast Iron } | |
| Nipples | in. at | \$ |
| Bushings | to in. at | \$ |
| Red'g } Couplings | to in. at | \$ |
| Inc'g } | | |
| Union | in. at | \$ |
| Meter | in. at | \$ |
| Lbs. Br. Stone | at | \$ |
| Lbs. Sand | at | \$ |
| Bags Cement | at | \$ |
| Paving Brick } Mack } | at | \$ |
| | Red } | |
| | Asphalt } | |
| Lead Joints | at | \$ |
| Leadite Joints | at | \$ |
| 4 Hrs. Foreman | at | \$ 2.50 |
| 19 Hrs. Common Labor | at | \$ 7.72 |
| Hrs. Common Labor | at | \$ |
| Hrs. Mason | at | \$ |
| Hrs. Mason's Helper | at | \$ |
| Hrs. Compressor | at | \$ |
| Compensation Ins. | | \$ 27 |
| Trucking | | \$ 1.00 |
| Builders' Use of Water | Patch | \$ 5.00 |
| Total \$ | | 29.95 |

24-173
Labor and Material Report

19 27

#25 Sherman Ave.

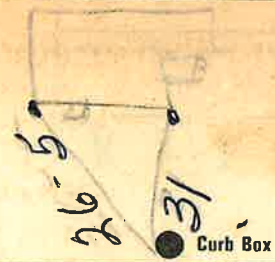

6 Main

Elev of Main at tap 45

Gate at

Gate at

27' to main
3/4" copper

Curb Box

old Tap shut off