
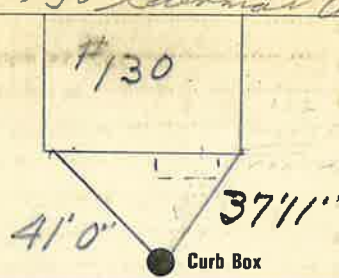


~~St~~  
~~Pl~~  
 SHERMAN Ave. No. 130  
 Name of Owner \_\_\_\_\_  
 Labor and Mat'l. Report DEC 2 1926  
  
 64 1/2" 61 1/2"  
 ● Curb Box  
 6" Main Elev. of Main at tap 4'  
 Gate at ● Gate at ●  
 3/4" COPPER ● Curb Box  
 LSM-5C-6-1-67

26-192  
 Labor and Material Report Dec 5 1926  
 TAP AT 130 Sherman Ave  
  
 #130  
 41'0" 37'11"  
 ● Curb Box  
 6" Main Elev. of Main at tap 4'  
 Gate at ● Gate at ●  
 TAX ID # 309.7-4-1  
 ● Curb Box  
 14' to main  
 3/4" COPPER

### LABOR AND MATERIALS

Copper	}	Connection	_____	\$	_____
Lead					
Curb	}	Cock	_____ in.	\$	_____
		Valve			
		T. S. & V.			
Service box	}	Short 3½ x 4½	_____	\$	_____
Old returned		Long 4½ x 5½			
Ft. <u>3/4</u> in.	}	Copper	Pipe at	\$	_____
		G.I.			
		G.I.			
Nipples	in. at	_____	\$	_____	
Bushings	to _____ in. at	_____	\$	_____	
Red'g	}	Coupl'gs	to _____ in. at	\$	_____
Inc'g					
Union	in. at	_____	\$	_____	
Meter	in. at	_____	\$	_____	
_____			\$	_____	
Compound Joints	at	_____	\$	_____	
Maintenance Foreman		_____	\$	_____	
Hrs. Water Maint. Man	—1 at	_____	\$	_____	
Hrs. Water Maint. Man	—2 at	_____	\$	_____	
Hrs. Garage Foreman	at	_____	\$	_____	
Hrs. Labor	at	_____	\$	_____	
Hrs. Compressor	at	_____	\$	_____	
_____			\$	_____	
Trucking		_____	\$	_____	
Pav't Patch		_____	\$	_____	
_____			\$	_____	
_____			\$	_____	
### Labor and Materials

Copper	}	Connection	<u>3/4</u>	\$	<u>3.20</u>
Lead					
Curb	}	Cock	<u>3/4</u> in.	\$	<u>1.00</u>
		Valve			
		T. S. & V.			
Service Box	}	Short 3½ x 4½	_____	\$	<u>1.30</u>
Old returned		Long 4½ x 5½			
1 1/4 Ft.	}	Copper	Pipe at	\$	<u>3.08</u>
		Galv. Iron			
		Cast Iron			
Nipples	in. at	_____	\$	_____	
Bushings	to _____ in. at	_____	\$	_____	
Red'g	}	Couplings	to _____ in. at	\$	_____
Inc'g					
Union	in. at	_____	\$	_____	
Meter	in. at	_____	\$	_____	
_____			\$	_____	
Lbs. Br. Stone	at	_____	\$	_____	
Lbs. Sand	at	_____	\$	_____	
Bags Cement	at	_____	\$	_____	
Paving Brick	}	Mack	at	\$	_____
		Red Asphalt			
Lead Joints	at	_____	\$	_____	
Leadite Joints	at	_____	\$	_____	
2 Hrs. Foreman		<u>6.25</u>	\$	<u>12.50</u>	
7 Hrs. Common Labor		<u>5.00</u>	\$	<u>35.00</u>	
8 Hrs. Common Labor		<u>4.08</u>	\$	<u>32.64</u>	
Hrs. Mason	at	_____	\$	_____	
Hrs. Mason's Helper	at	_____	\$	_____	
Hrs. Compressor	at	_____	\$	_____	
Compensation Ins.		_____	\$	<u>22</u>	
Trucking		_____	\$	<u>1.00</u>	
Builders' Use of Water		_____	\$	_____	
Total					<u>\$17.50</u>