


**Labor and Materials**

1	Copper	Lead	Connection	.....	\$ 2.60	
1	Curb	Cock Valve	T.S. & V.	..... in.	\$ 2.27	
1	Service Box	Short 3/4x1 1/2	Long 4 1/2x5 1/2	} Old returned (Buff. or Rdway)	\$ 1.38	
14	Ft.	Copper Galv. Iron	Cast Iron			Pipe at
	Nipples	.....	in. at	.....	\$	
	Bushings	.....	to	..... in. at	\$	
	Red'g Inc'g	Couplings	.....	to	..... in. at	\$
	Union	.....	in. at	.....	\$	
	Meter	.....	in. at	.....	\$	
	Lbs. Br. Stone	at	.....	.....	\$	
	Lbs. Sand	at	.....	.....	\$	
	Bags Cement	at	.....	.....	\$	
	Paving Brick	Mack Red Asphalt	at	.....	\$	
	Lead Joints	at	.....	.....	\$	
	Leadite Joints	at	.....	.....	\$	
1 1/2	Hrs. Foreman	at	.....	.....	\$ 31	
1 1/4	Hrs. Common Labor	at	Tapper	.....	\$ 63	
8	Hrs. Common Labor	at	.....	.....	\$ 3.60	
	Hrs. Mason	at	.....	.....	\$	
	Hrs. Mason's Helper	at	.....	.....	\$	
	Hrs. Compressor	at	.....	.....	\$	
	Compensation Ins.	.....	.....	.....	\$ .14	
	Trucking	.....	.....	.....	\$ 1-	
	Builders' Use of Water	.....	.....	.....	\$	
	<b>Total</b>				\$ 14.45	

Labor and Material Report 4-15-1931

# 134 Sherman Ave

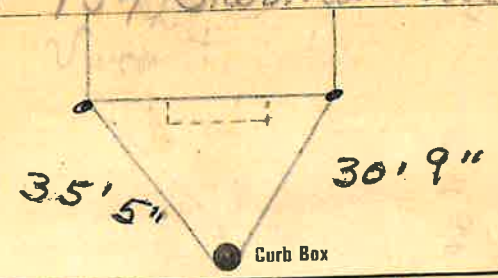

Measured in 7-14-60.

6 Main Eley of Main at tap 5

Gate at TAX ID # 309.7-4-3 Gate at

● Curb Box  
14' to MAIN  
Copper